

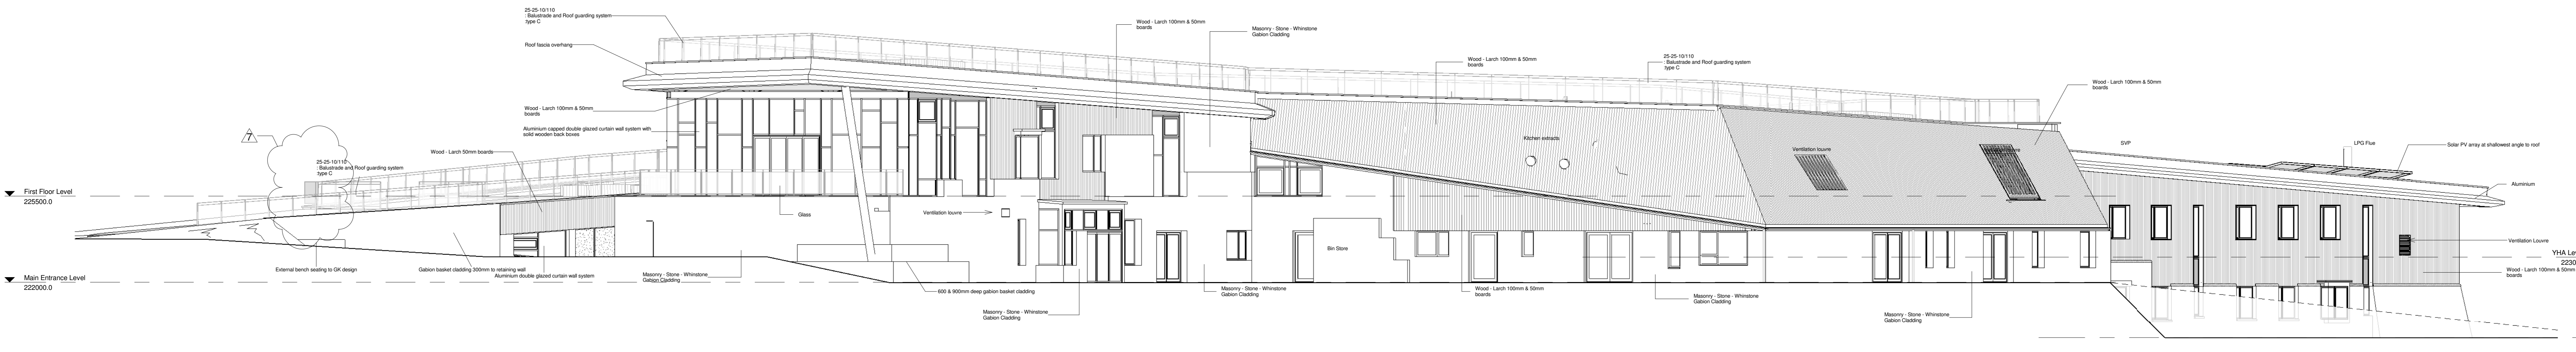



NOTES:
 1. DO NOT SCALE from the drawing
 2. Further dimensions required to be requested from the project technical team
 3. Report discrepancies to JDDK project team immediately
 4. This model file contains the following consultants model files:
 a) 3736-CAD-ZX-XX-M3-ME-001-The_Sill
 b) The_Sill_Model (2015.06.12)

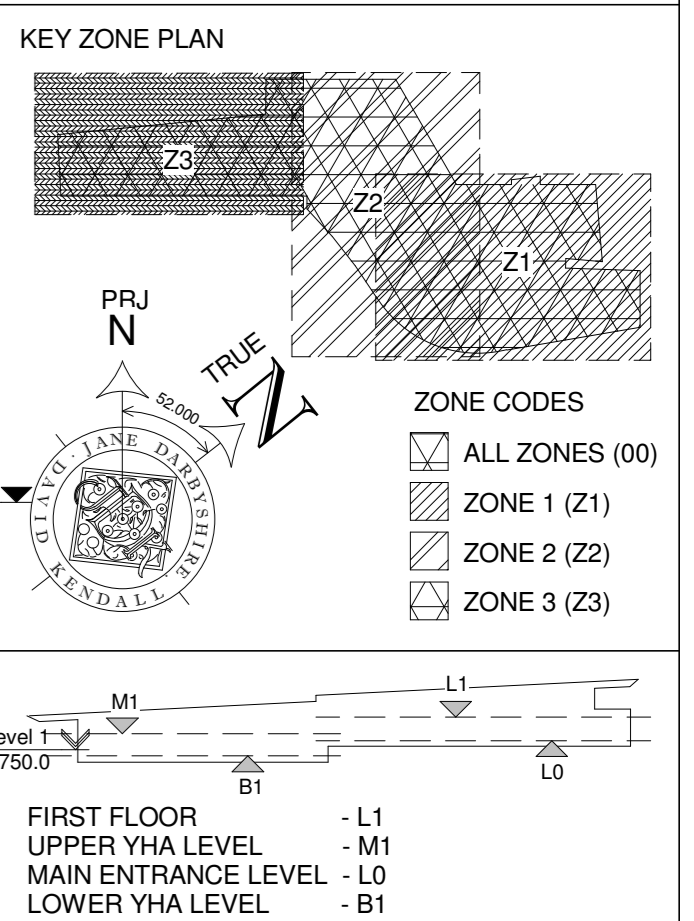


1 North Elevation
 1 : 100

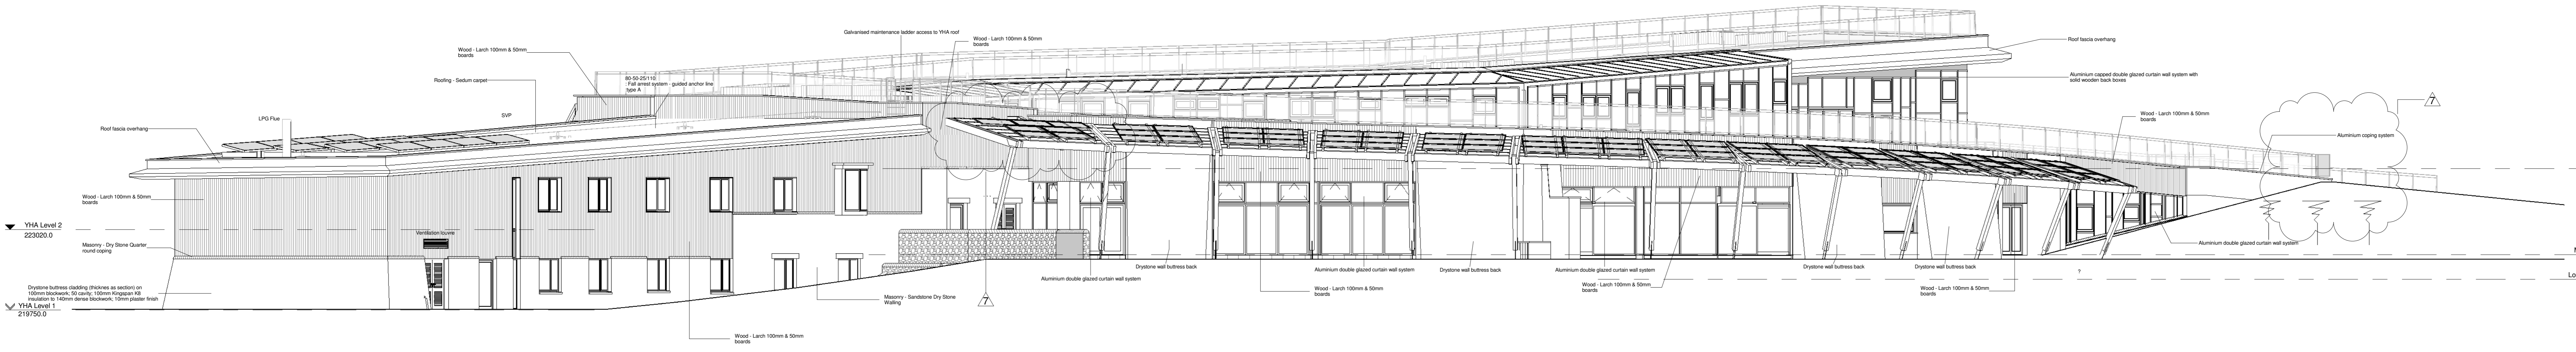

2 South Elevation
 1 : 100

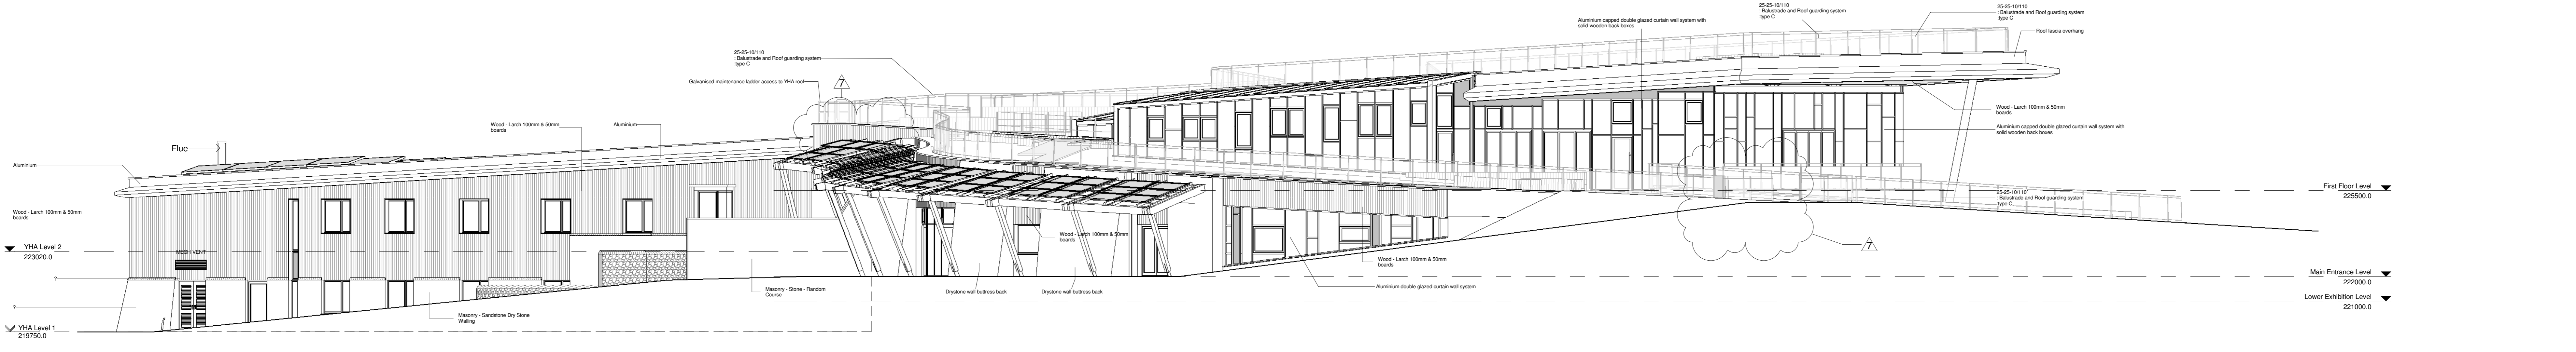

3 East Elevation
 1 : 100

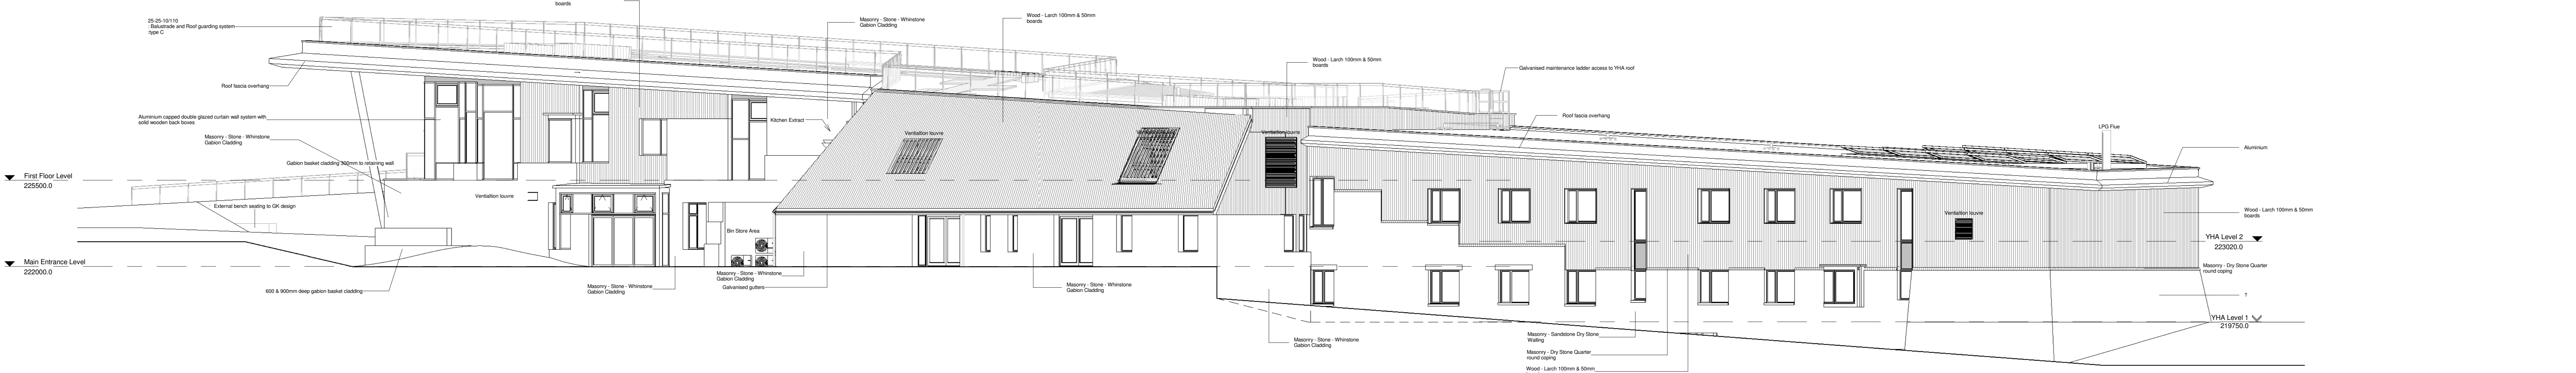

4 West Elevation
 1 : 100

REV	BY	DATE	DESCRIPTION
E.7	MM	2017.03.29	Add external solar panel to canopy. Add small sitting area to roof access point.
C.5	MM	2017.05.25	AS BUILT ISSUE
C.5	MM	2017.04.11	Adjust YHA side thermal panel orientation to suit installers recommendations.
C.4	MM	2017.03.16	Add extra battens to YHA roof. Remove materials in line with ERM.
C.3	MM	2017.02.16	Add Conservatory and glass screen wall to north lawn.
C.2	MM	2015.10.16	Update Solar PV to 10kW roof based on revised planning application.
C.1	MM	2015.09.29	Final Issue for Construction

REVISION LOG
Jane Darbyshire and David Kendall Ltd
 Chartered Architects and Landscape Architects
 Millmount Portland Road
 Newcastle Upon Tyne
 NE5 3AL
 Telephone: +44 (191) 286 5811
 Facsimile: +44 (191) 286 5870
 email: millmount@jddk.co.uk
 www.jddk.co.uk

CLIENT NNPA/YHA	
PROJECT TITLE THE SILL PROJECT	
TITLE ELEVATIONS SHEET - VE	
MAIN CONTRACTOR SIR ROBERT McALPINE	
QUANTITY SURVEYOR GARDNER & THEOBOLD	M&E CONSULTANT CAD21
STRUCTURAL CONSULTANT PATRICK PARSONS	OTHER CONSULTANT
DRAWING No. SIL-JDDK-XX-XX-DR-A-(20)3001A	REV C7
JDDK PROJECT REF: 3314	JDDK DRAWING NO: 30.01A
SCALE: 1 : 100 @ A0	ISSUE DATE: 09/17/15
DRAWN BY: Author	CHECKED BY: Checker
STATUS: S1	PURPOSE OF ISSUE: AS BUILT