


WE OWN EVERYTHING ON THE PLAN
 AND ALL THE LAND SURROUNDING - SEE FARM PLAN

Scale 1:1250
~~Scale 1:50~~
~~1:150~~

Downstairs now
 incorporated into house
 "Uncle Duncan's flat"
 upstairs part of Hawthorn

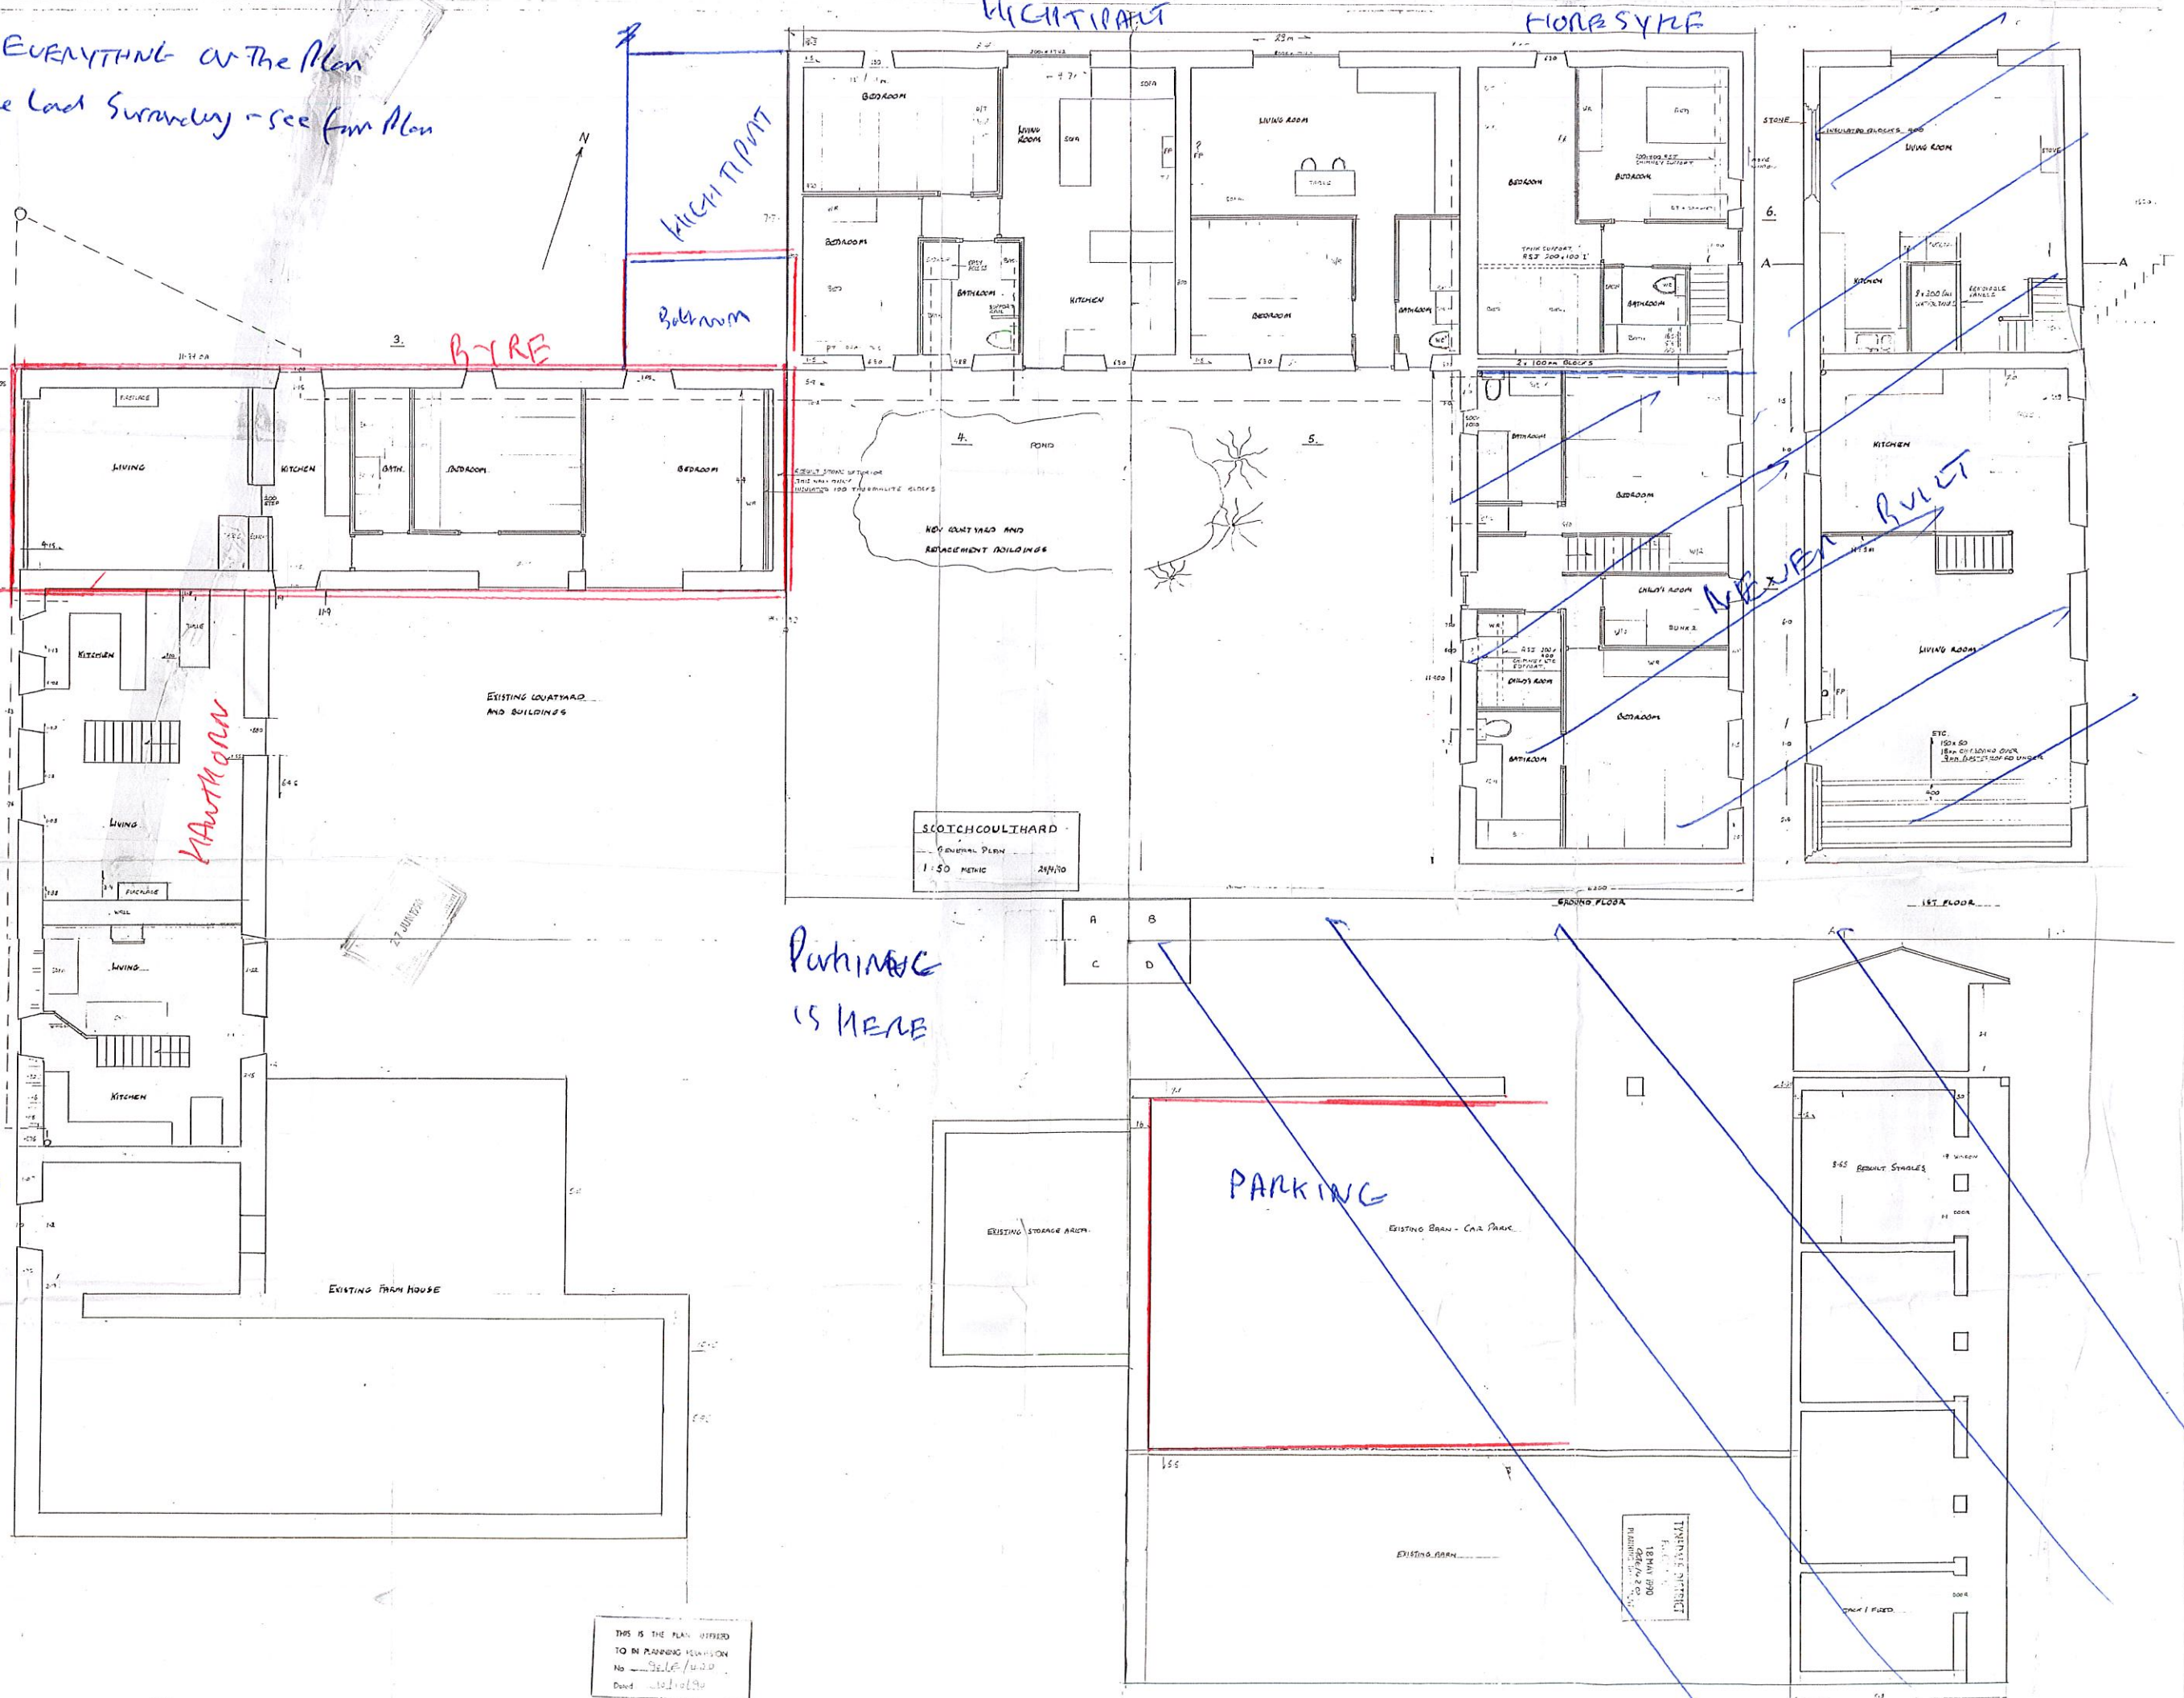

THIS IS THE PLAN OFFERED
 TO IN PLANNING PERMISSION
 No. 02/01/430
 Date 10/11/00

TYPICAL STREET
 18 MAY 2000
 04/11/00